CVS Health®


Mount Prospect

Technology
As Built Drawing Set

CVS Health
Coram
1471 East Business Center Dr.
Mount Prospect, IL. 60056


MNC

CVS VDC ENGINEERING

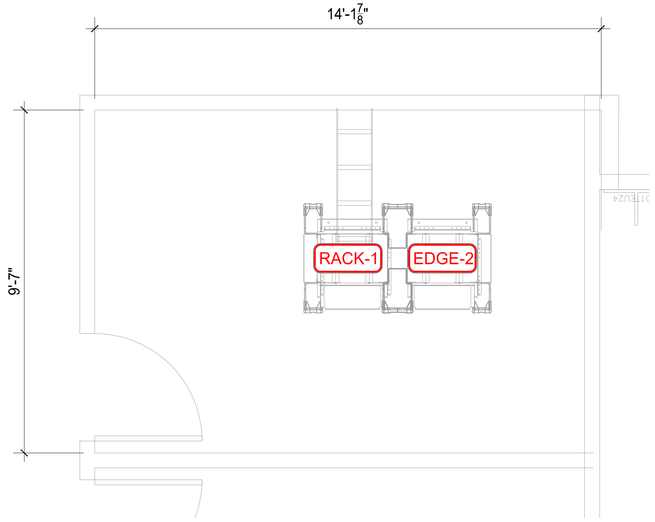


2 1ST FLOOR IDF 1B

SCALE: 1/2" = 1'-0"

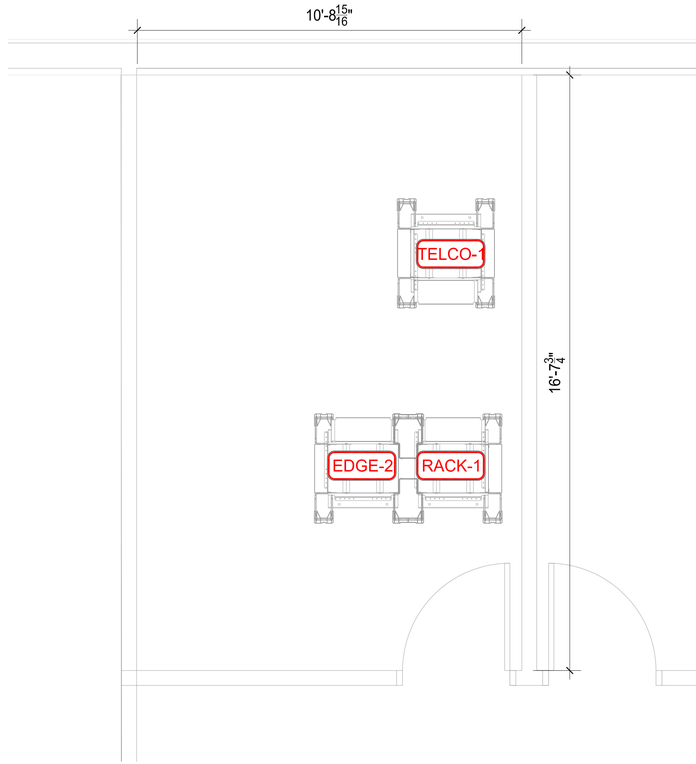

1 1ST FLOOR MDF 1A

SCALE: 1/2" = 1'-0"

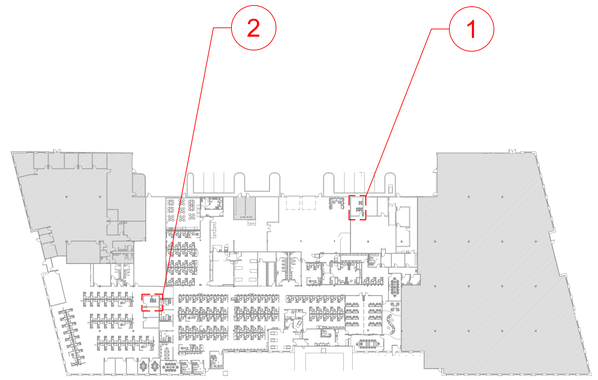

1ST FLOOR KEY PLAN

FIELD TECHNICIAN TO COMPLETE INFORMATION BELOW:

DATE: TRACK #: NAME: SIGNATURE: COMPANY: NUMBER OF CABLES AT PATCH PANEL: NUMBER OF CABLES ON PLAN:

CVSHealth®

DISPENSING: YES NO

DIVISION: PBM

BUSINESS UNIT: Coram

UPDATE: 06-29-2023

UPDATED BY: Alexander Olivero

MNC


1471 East Business Center Dr.
Mount Prospect, IL. 60056

R-1

C1 C2 C3 C4 C5 C6

CERTIFICATION

CVS VDC ENGINEERING

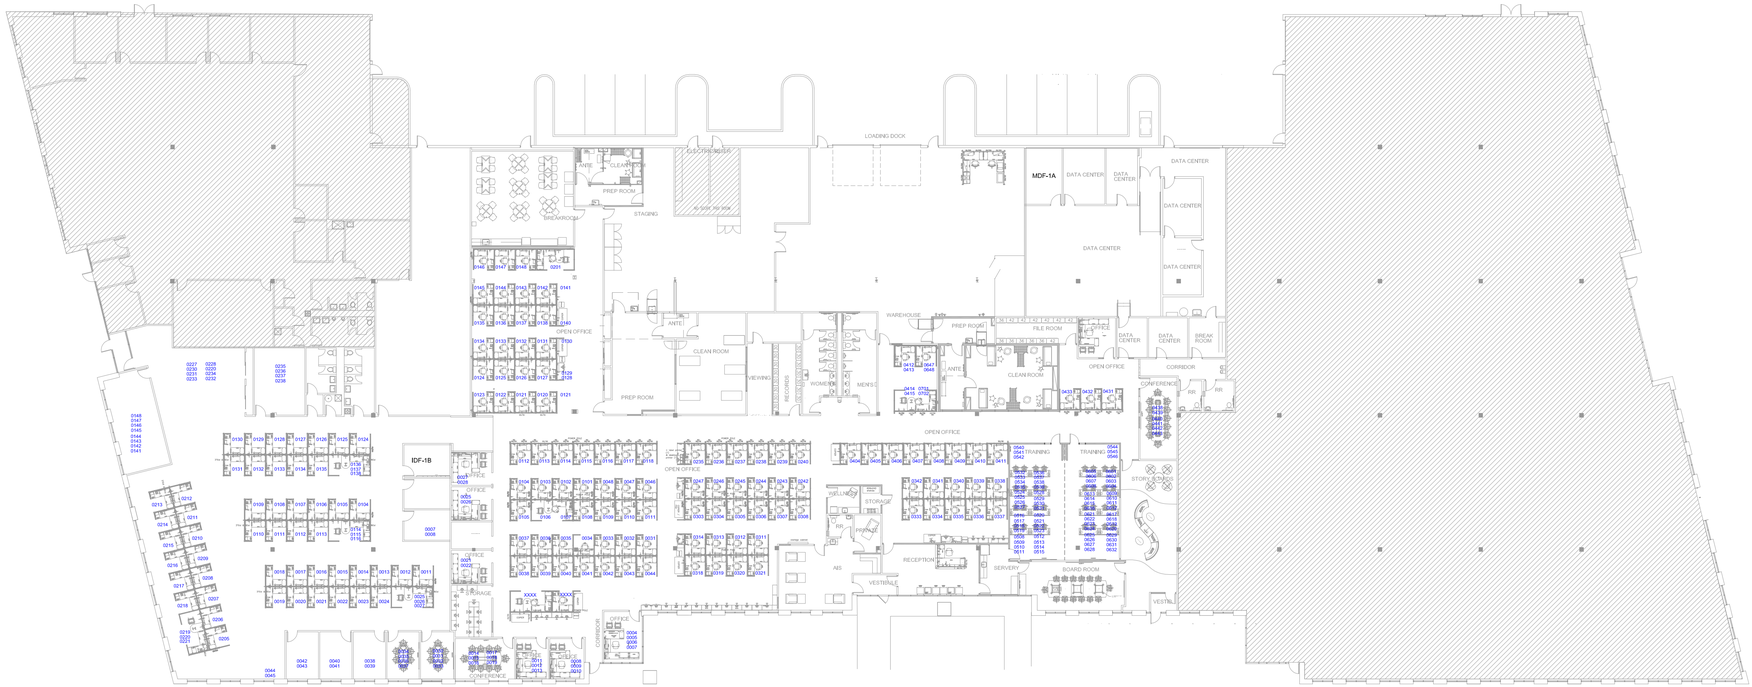

1 1ST FLOOR CABLING PLAN

SCALE: 1/16"=1'-0"

FIELD TECHNICIAN TO COMPLETE INFORMATION BELOW:

DATE: TRACK #: NAME: SIGNATURE: COMPANY: NUMBER OF CABLES AT PATCH PANEL: NUMBER OF CABLES ON PLAN:

CVSHealth®

DISPENSING: YES NO

DIVISION: PBM

BUSINESS UNIT: Coram

UPDATE: 06-29-2023

UPDATED BY: Alexander Olivero

MNC

1471 East Business Center Dr.
Mount Prospect, IL. 60056

C-1A

C1 C2 C3 C4 C5 C6

CERTIFICATION

CVS VDC ENGINEERING

CEILING PLAN LEGEND

LESS THAN 10 FEET	
BETWEEN 11 AND 15 FEET	
BETWEEN 16 AND 25 FEET	
MORE THAN 25 FEET	



1 1ST FLOOR CEILING HEIGHT PLAN
SCALE: 1/16"=1'-0"

FIELD TECHNICIAN TO COMPLETE INFORMATION BELOW:

DATE: TRACK #: NAME: SIGNATURE: COMPANY: NUMBER OF CABLES AT PATCH PANEL: NUMBER OF CABLES ON PLAN:

CVS Health®

DISPENSING: YES NO

DIVISION: PBM

BUSINESS UNIT: Coram

UPDATE: 06-29-2023
UPDATED BY: Alexander Olivero

MNC

1471 East Business Center Dr.
Mount Prospect, IL. 60056

H-1A

C1 C2 C3 C4 C5 C6

CERTIFICATION

CVS VDC ENGINEERING



1 FLOOR PLAN

SCALE: 3/32"=1'-0"

PLAN LEGEND

PHARMACY AREA	
CLEAN ROOM	
COOLER	
IT ROOM	
AIS ROOM	

FIELD TECHNICIAN TO COMPLETE INFORMATION BELOW:

DATE: TRACK #: NAME: SIGNATURE: COMPANY: NUMBER OF CABLES AT PATCH PANEL: NUMBER OF CABLES ON PLAN:

CVSHealth®

DISPENSING: YES NO

DIVISION: PBM

BUSINESS UNIT: Coram

UPDATE: 06-29-2023

UPDATED BY: Alexander Olivero

MNC


1471 East Business Center Dr.
Mount Prospect, IL. 60056

P-1A

C1 C2 C3 C4 C5 C6

CERTIFICATION

CVS VDC ENGINEERING

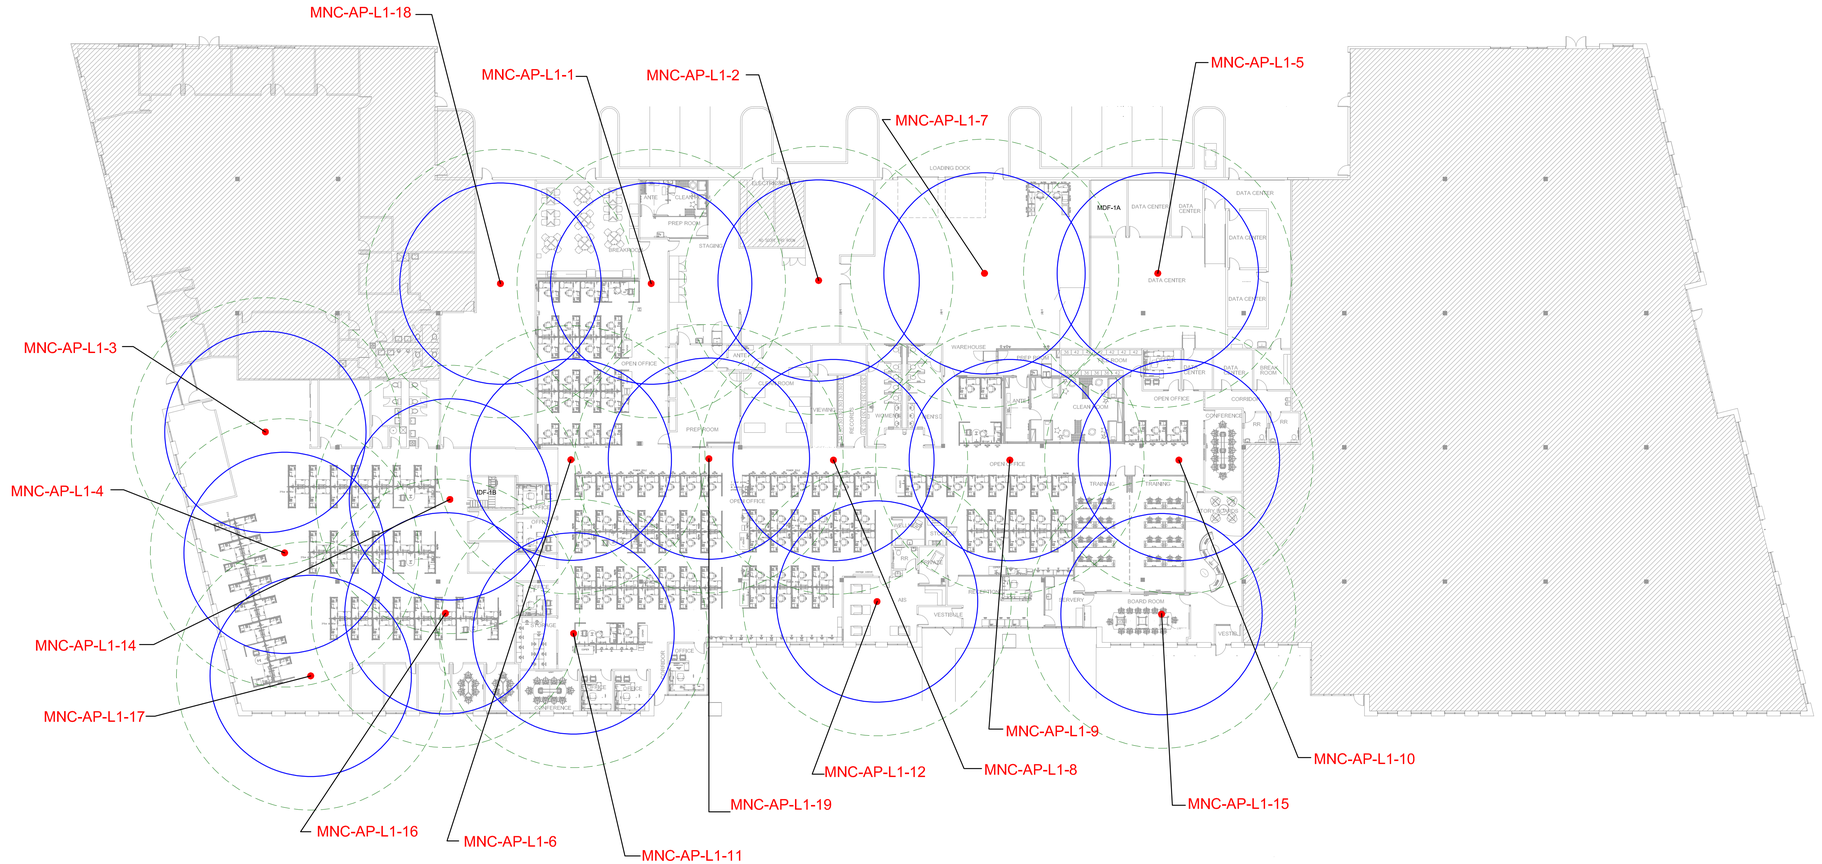

1 1ST FLOOR WIRELESS PLAN

SCALE: 3/64" = 1'-0"

0' 5' 10' 20' 30'

FIELD TECHNICIAN TO COMPLETE INFORMATION BELOW:

DATE: TRACK #: NAME: SIGNATURE: COMPANY: NUMBER OF CABLES AT PATCH PANEL: NUMBER OF CABLES ON PLAN:

ROOF

VDC ROOM — WIFI RISER PANEL — 18 AP's

1ST FLOOR

cvsHealth®

DISPENSING: YES NO

DIVISION: PBM

BUSINESS UNIT: Coram

UPDATE: 06-29-2023

UPDATED BY: Alexander Olvero

MNC


1471 East Business Center Dr.
Mount Prospect, IL. 60056

W-1A

C1 C2 C3 C4 C5 C6

CERTIFICATION

CVS VDC ENGINEERING

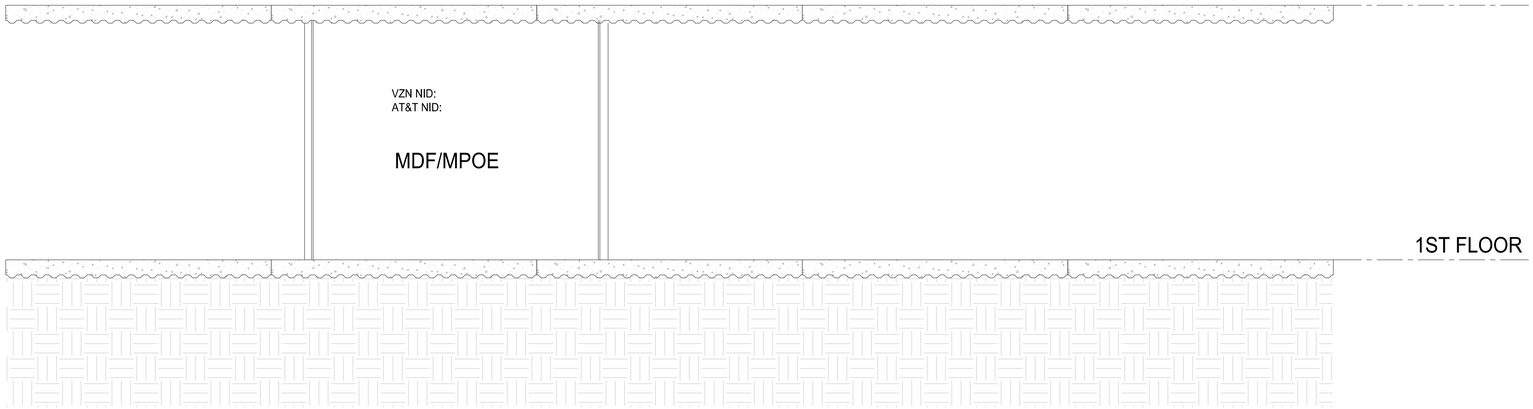

1 TELECOM RISER DIAGRAM
SCALE: NTS

FIELD TECHNICIAN TO COMPLETE INFORMATION BELOW:

DATE: TRACK #: NAME: SIGNATURE: COMPANY: NUMBER OF CABLES AT PATCH PANEL: NUMBER OF CABLES ON PLAN:

CVSHealth®

DISPENSING: YES NO

DIVISION: PBM

BUSINESS UNIT: Coram

UPDATE: 06-29-2023

UPDATED BY: Alexander Olvero

MNC

1471 East Business Center Dr.
Mount Prospect, IL. 60056

T-1

C1 C2 C3 C4 C5 C6

CERTIFICATION